


PIPE / CHANNEL NUMBER	1	2	3	4	5	6	7	8	9	10	11	12	13	14	15	16	17	18	19	20	21	22	23	24	25	26	27	28	27	11
STREAM DESCRIPTION	Raw Sewage	HOW Return SNL Filtrate	Raw Sewage	Screenings	Grit	Raw Sewage	Tank Effluent	Raw Sludge	Tank Effluent New	Tank Effluent Old	Secondary Effluent Old	Waste Activated Sludge Old	Return Sludge New	Secondary Effluent New	Waste Activated Sludge New	Primary Digester Feed	Primary Digester Sludge	Secondary Digester Sludge	Dewatered Digested Sludge	Combined Waste Activated Sludge	Dewatered Waste Activated Sludge	Combined Secondary Effluent	Effluent to River	Chlorinated Water	2nd Class Water	S.N.L.	WAS dewatering Filtrate	2nd Digested dewatering Filtrate	Works Sewage	
ADWF (m3/day)	12.2 MLD	408 m3/day	12.2 MLD	2 m3/day	0.5 m3/day	12.6 MLD	12.5 MLD	105 m3/day @ 3%	8.5 MLD	4 MLD	3.91 MLD	89 m3/day @ 1.0%	8.5 MLD	8.255 MLD	245 m3/day @ 0.7%	105 m3/day @ 3%	105 m3/day @ 1.8%	63 m3/day @ 3%	9 m3/day @ 22%	334 m3/day @ 0.8%	18 m3/day @ 15%	12.165 MLD	11.5 MLD		6.22 liters/second	42 m3/day	312 m3/day	54 m3/day	50 m3/day	
PWWF (m3/day)	37.2 MLD		37.2 MLD			37.6 MLD	37.5 MLD	160 m3/day																						
DIAMETER / SIZE	600 dia inlet sewer 600 w x 1600 ht	150 ID rising main	600 w x 1600 ht			600 w x 1600 ht	600 ID pipe	200 ID pipe & 150 ID pipe	600 ID pipe	450 ID pipe	450 ID pipe	150 ID pipe	250 ID pipe	600 ID pipe	150 ID pipe	150 ID pipe	150 ID pipe	150 ID pipe	150 ID pipe	150 ID pipe	200 ID pipe	700 ID pipe	700 ID pipe	75 ID pipe	126 ID pipe	150 ID pipe	100 ID pipe	100 ID pipe	110 sewer pipe	
MATERIAL	Concrete Launder	PE-HD pipe	Concrete Launder			Concrete Launder	PE-HD pipe	PE-HD pipe	PE-HD pipe	PE-HD pipe	PE-HD pipe	PE-HD pipe	PE-HD pipe	PE-HD pipe	PE-HD pipe	PE-HD pipe	PE-HD pipe	PE-HD pipe	PE-HD pipe	HDGMS	HDGMS	HDGMS	PE-HD pipe	PE-HD pipe	PE-HD pipe	PE-HD pipe	PE-HD pipe	PE-HD pipe	uPVC class 6.3	

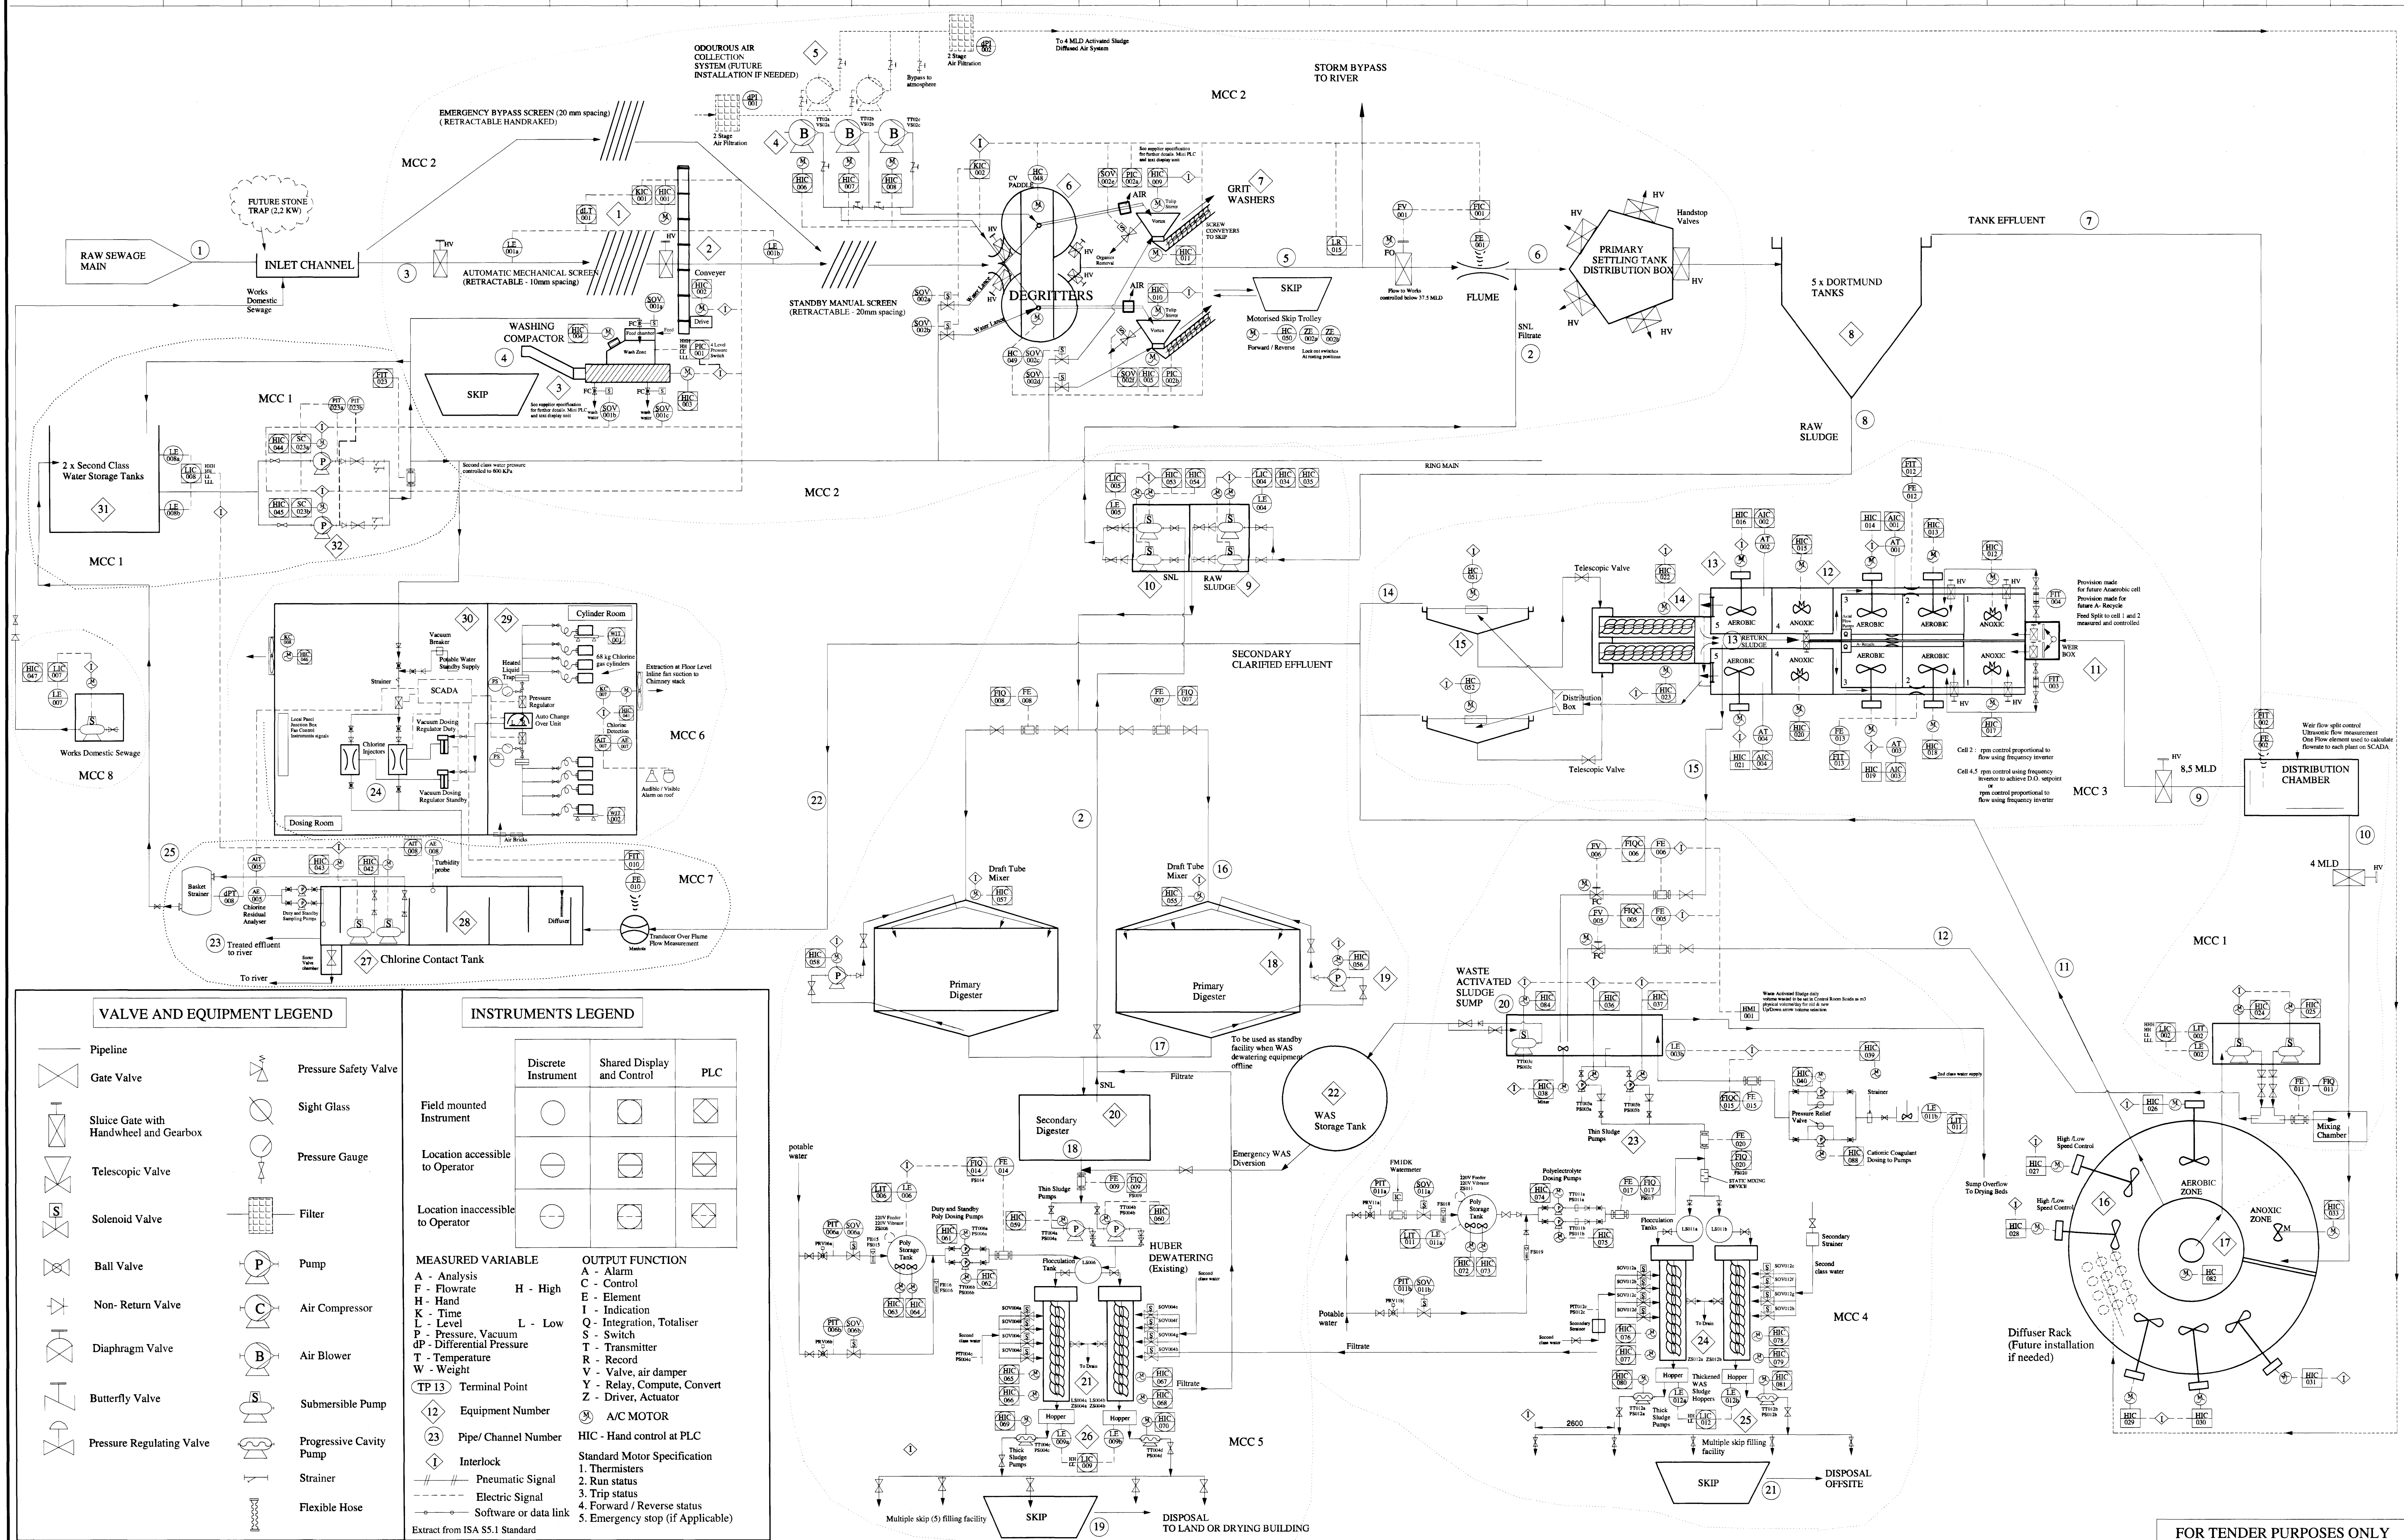

VALVE AND EQUIPMENT LEGEND

	Pipeline		Pressure Safety Valve
	Gate Valve		Sight Glass
	Slice Gate with Handwheel and Gearbox		Pressure Gauge
	Telescopic Valve		Filter
	Solenoid Valve		Pump
	Ball Valve		Air Compressor
	Non-Return Valve		Air Blower
	Diaphragm Valve		Submersible Pump
	Butterfly Valve		Progressive Cavity Pump
	Pressure Regulating Valve		Strainer
			Flexible Hose

INSTRUMENTS LEGEND

Discrete Instrument	Shared Display and Control	PLC

Field mounted Instrument

Location accessible to Operator

Location inaccessible to Operator

MEASURED VARIABLE

A - Analysis
C - Control
F - Flowrate
H - Hand
K - Time
L - Level
P - Pressure, Vacuum
qP - Differential Pressure
T - Temperature
W - Weight

TP 13 Terminal Point

23 Pipe/Channel Number

OUTPUT FUNCTION

A - Alarm
C - Control
E - Element
I - Indication
Q - Integration, Totaliser
S - Switch
T - Transmitter
R - Record
V - Valve, air damper
Y - Relay, Compute, Convert
Z - Driver, Actuator

HIC - Hand control at PLC

Standard Motor Specification

1. Thermistors
2. Run status
3. Trip status
4. Forward / Reverse status
5. Emergency stop (if Applicable)

Extract from ISA S5.1 Standard

PLANT / EQUIPMENT ITEM	1	2	3	4	5	6	7	8	9	10	11	12	13	14	15	16	17	18	19	20	21	22	23	24	25	26	27	28	29	30	31	32
DESCRIPTION	Mechanical Screen	Screenings Conveyor	Screenings Washer Compactor	Grit Air Lift Blowers 1 x Duty 1 x Standby	Odour Blowers 1 x Duty 1 x Standby	Vortex Degritters	Grit Separators 2 x 0.55 KW covers 2 x 1.1 KW	5 x Dortmund Primary Settling Tanks (Existing)	Raw Sludge Submersible Pump (Existing)	SNL Submersible Pump (Existing)	8.5 MLD Bardenpho Activated Sludge Plant (Existing)	8.5 MLD A/S Anoxic Cells Mixers	8.5 MLD A/S 2 speed Aerators	8.5 MLD A/S Return Sludge Screw Pumps	4 MLD A/S Clarifiers x 2	4 MLD A/S Sludge Dewatering Equipment (Existing)	4 MLD A/S Clarifier Mixers (Existing)	Primary Digester	Primary Digester Mixing Pump	Secondary Digester	Digested WAS Sludge Dewatering Equipment	WAS Digester	WAS Pumps	WAS Dewatering	WAS Thick Sludge Pumps	Secondary Digester Thick Sludge Pumps (Existing)	Chlorination Tank Submersible Pumps	Chlorination Dosing Room	Chlorination Dosing Room	2nd Class Water Storage tanks	2nd Class Water Booster Pumps	
EQUIPMENT DETAIL	10mm spacing Automatic Retractable					6 x Puffins 2 x 1.1 KW	2 x 0.55 KW covers 2 x 1.1 KW	10.3m dia 8.5m depth 5 Cells per lane 970 m3 volume	1 x Duty 1 x Standby	1 x Duty 1 x Standby	2 Lanes of 894 m3 5 Cells per lane 14m x 14m x 4.5m	In cells 1 and 4	In cells 2, 3 and 5	1 x Duty 1 x Standby	4850 m3	2 Huber Ross 3/2 Rotamix Screw Presses	24m dia clarifier, 3m depth	Two x 1800 m3 No Heating No Gas collection	Gorman Rupp 2 x Duty	28m x 10m x 5m 800 m3	2 x Huber Ross 3/2 Rotamix Screw Presses	Volume 600 m3 storage for feed 1 x WAS DIG Feed	42 m3/hr	2 x Screw Press	2 x Netch 1 x Duty 1 x Standby	1 x duty 1 x standby	1.38m x 9.8m x 3m ht = 1.58m Volume = 64 m3					
DUTY	2.2 KW (future start-up)		Washer 3.5 KW Compactor 4 KW																													
KW	2.2 KW	1.1 KW	7.5 KW	2 x 5.5 KW	15 KW	2 x 1.1 KW	10.8 KW		2 x 15 KW	2 x 15 KW	4 x 6 KW	6 x 4 KW	1 x 8 KW	2 x 1 KW	3 x 37 KW 1 x 4 KW	1 KW bridge drive	1 KW		30 KW								11 KW					2 x 15 KW

REVISIONS

Revision	Date	Description
B	Oct 2009	As Built
A	August 2007	

Modifications to the following:
1. Dewatering Plant: Various
2. Chlorination Plant: Effluent added
3. Second Class Water Pumps
Value added

AS BUILT

DATE: 03/02/2012 SIGN: [Signature]

REDUCED PLAN USE SCALE BELOW

70mm ON ORIGINAL PLAN

LEGEND OF EXISTING UNDERGROUND SERVICES

SEWERS AND M.H.S

STORM WATER DRAIN AND M.H.S

WATER MAINS AND VALVES

ELECTRICITY CABLES

TELKOM CABLES

UNDERGROUND SERVICES CHECKED

SERVICE	DATE	SIGNATURE
S.W. DRAINS		
SEWERS		
WATER MAINS		
TELKOM CABLES		
ELECTRIC CABLES		
SPOORNET CABLES		
E.S.C. CABLES		
ON PIPE LINE		

NOTE: Only underground services affected by new construction work are shown.
Care must be taken during excavations for road foundations, trenches etc. to avoid damage to underground services such as sewers, drains, cables, water mains and connections. Wherever possible these must be located before work proceeds.

NOTE: No construction work to commence until land and service acquisitions have been completed

Acquisitions completed:

Date: _____ Engineer: _____

DEPARTMENT OF WASTEWATER MANAGEMENT

ETHEKWINI MUNICIPALITY

ETHEKWINI WATER & SANITATION

Contract No. **WS. 5735**

Project Title
VERULAM WASTEWATER TREATMENT WORKS UPGRADE: REPLACEMENT OF BIOFILTERS WITH 8.5 MLD ACTIVATED SLUDGE PLANT

Project No. Y 6065

Drawing Title
PROCESS AND INSTRUMENTATION DIAGRAM

Reference Drgs. Scales: _____ Date: _____
 Surveyed: _____ Date: 3 September 2006
 Drawn: M. Graham Date: _____
 Designed: M.G./B.A.P./K.B. Date: 3 September 2006

Works Project Engineer: _____
 Manager: (Design) _____
 Deputy Head: Technical Services: _____

Drawing No. **60463-10** Sheet **1** Rev. **B**